
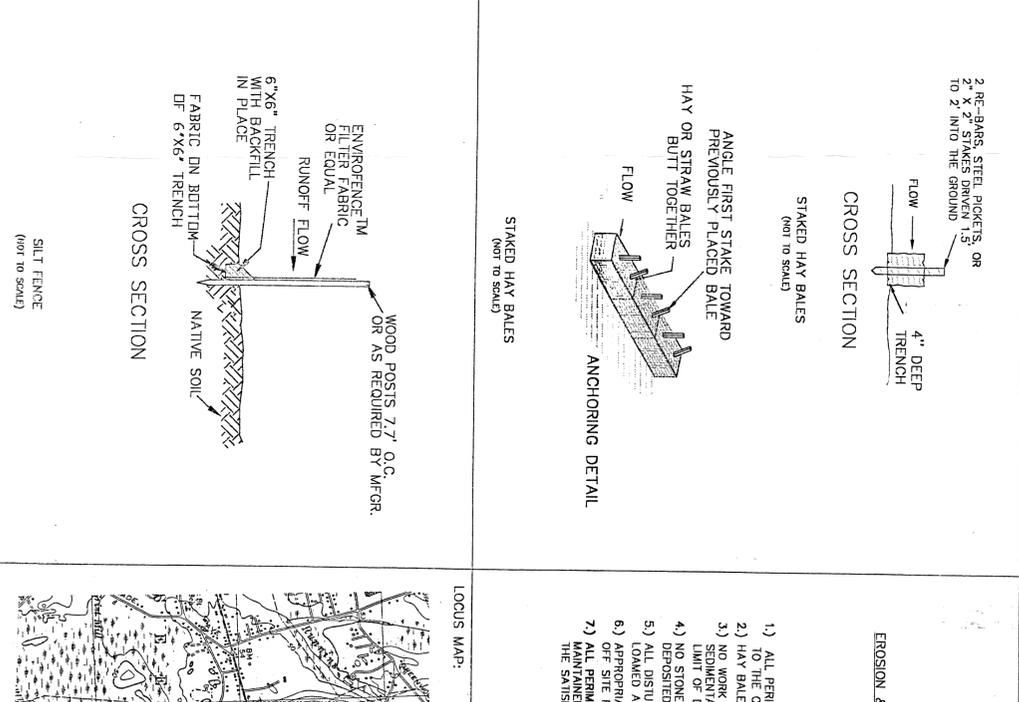
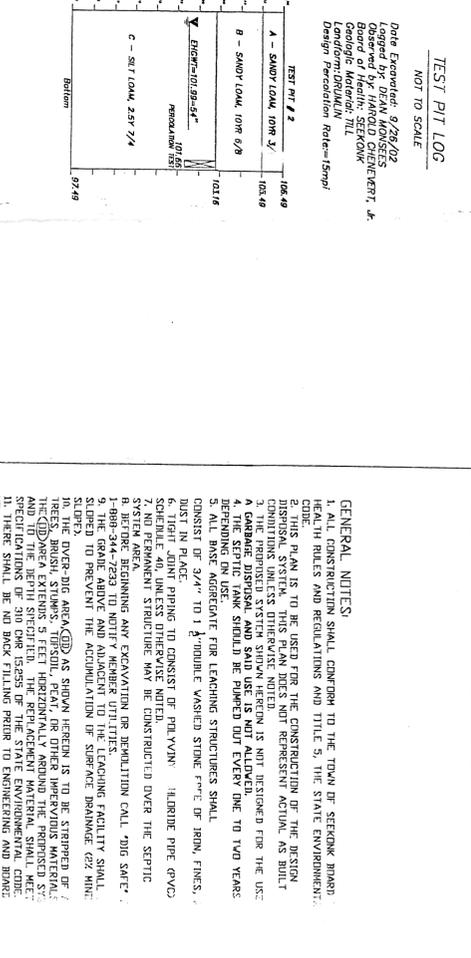
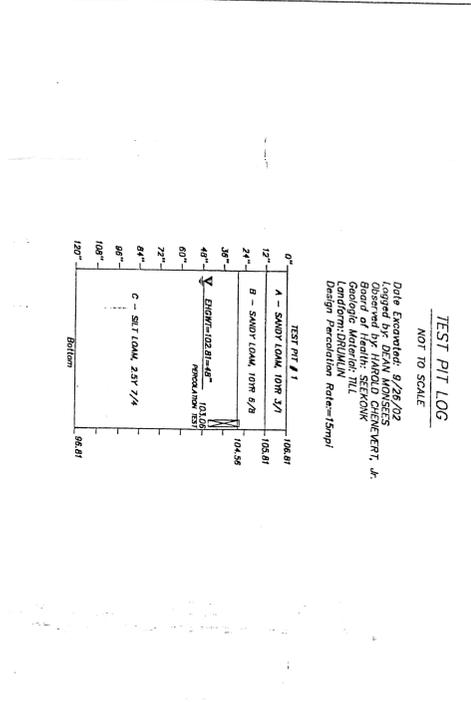
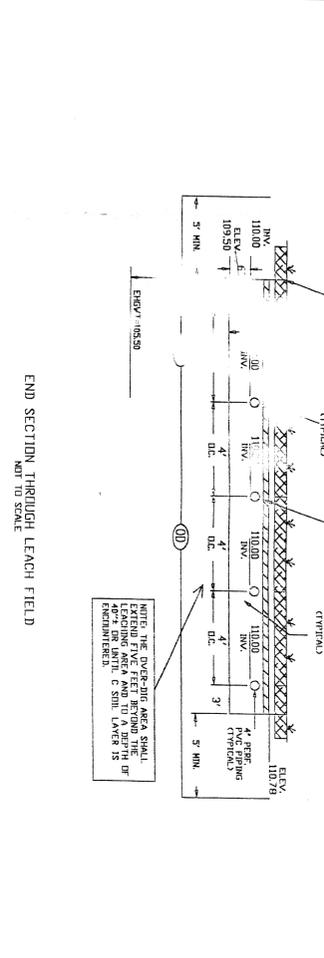
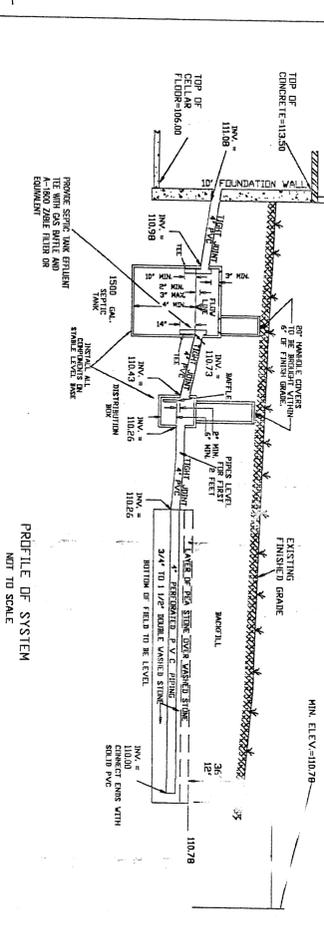


SCALE: 1"=20'

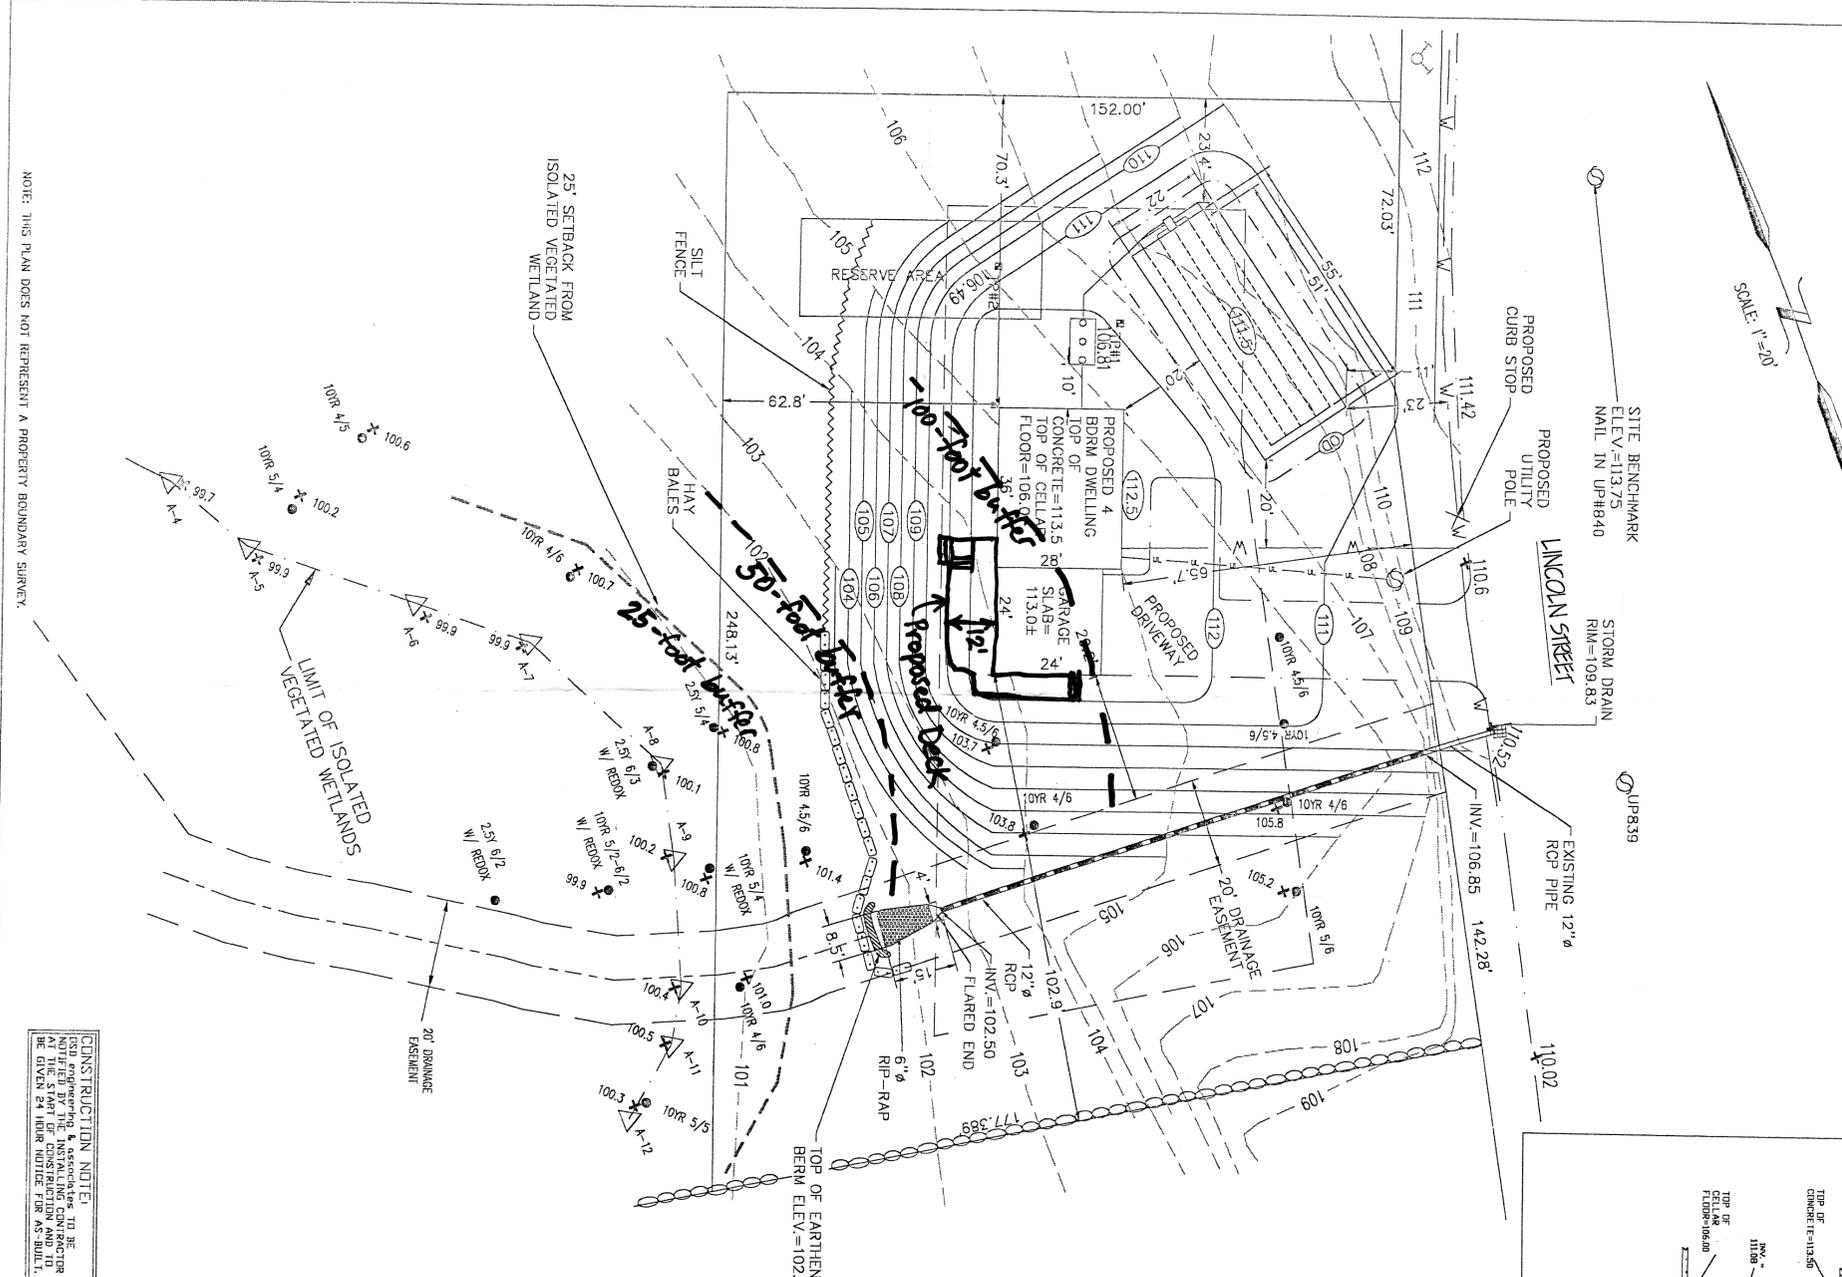

EROSION & SEDIMENTATION CONTROL

- 1) ALL PERIMETER EROSION AND SEDIMENTATION CONTROLS MUST BE INSTALLED PRIOR TO THE COMMENCEMENT OF EARTHEN BERM CONSTRUCTION.
- 2) HAY BALES SHOULD BE INSTALLED IN ACCORDANCE WITH THE DETAILS PROVIDED.
- 3) NO WORK IS TO OCCUR ON THE WETLAND SIDE OF THE PERIMETER EROSION AND SEDIMENTATION CONTROLS. ALL PERIMETER CONTROLS SHALL BE AS THE PRODUCT LIMIT OF DISTURBANCE.
- 4) NO STONES, BRUSH, CONSTRUCTION DEBRIS, LITTER, OR OTHER MATERIALS ARE TO BE DEPOSITED ON THE WETLAND SIDE OF THE EROSION AND SEDIMENTATION CONTROLS.
- 5) ALL DISTURBED SOILS NOT DESIGNATED FOR OTHER SURFACE TREATMENT ARE TO BE LOADED AND SEEDED IMMEDIATELY FOLLOWING FINAL GRADING.
- 6) APPROPRIATE PRECAUTIONS SHOULD BE TAKEN TO PREVENT THE TRANSPORT OF SOIL OFF SITE FROM CONSTRUCTION EQUIPMENT.
- 7) ALL PERIMETER EROSION AND SEDIMENTATION CONTROLS MUST BE PROPERLY MAINTAINED THROUGHOUT THE CONSTRUCTION PERIOD UNTIL THE SOILS HAVE BEEN STABILIZED TO THE SATISFACTION OF THE ENGINEER AND THE SEWERAGE COMMISSION.

LOCUS MAP:

DESIGN CALCULATIONS

FLOW: $(400 \times 100) / (60 \times 60) = 440 \text{ gpd } 880 \text{ PEAK}$

SEPTIC TANK: $1500 \text{ GAL. TANK } > 880$

LEACHING FIELD: $\text{RATE} = (0.17) \times 57 \text{ gpd FFR PER } = 1590 \text{ CLASS III SOIL}$

MINIMUM SIZE: $(440 \text{ gpd}) / (27 \text{ gpd/ft}^2) = 16 \text{ SF}$

USE: $2' \times 5' = 10 \text{ SF } > 16 \text{ SF}$

LEGEND

- EXISTING SPOT GRADE: A-10.52
- DISSEMINATION BOX: [Symbol]
- SEPTIC TANK: [Symbol]
- WATER LINE: [Symbol]
- OVER-DIG: [Symbol]
- PERFORATED PIPE: [Symbol]
- HAY BALES: [Symbol]
- SILT FENCE: [Symbol]
- DITCH LINE: [Symbol]
- EXISTING SPOT GRADE: A-10.52
- PROPOSED SPOT GRADE: (6.3)
- PROPOSED CENTER: (6.3)
- LIMIT OF WETLANDS: A-11
- LIMIT OF WETLAND SETBACK: [Symbol]
- SOIL SAMPLE POINTS: 25' 5/4

REVISIONS

NOV 18 2002
Con. Comm.
Received
RDA
30-1-1000

GENERAL NOTES:

1. ALL CONSTRUCTION SHALL CONFORM TO THE TOWN OF SEENKAM BOARD HEALTH RULES AND REGULATIONS AND TITLE 5, THE STATE ENVIRONMENTAL CONSTRUCTION SYSTEM. THIS PLAN DOES NOT REPRESENT ACTUAL AS BUILT CONDITIONS UNLESS OTHERWISE NOTED.
2. CONSTRUCTION SHALL BE IN ACCORDANCE WITH ALL APPLICABLE TOWN AND STATE REGULATIONS UNLESS OTHERWISE NOTED.
3. THE SEPTIC TANK SHALL BE CONSTRUCTED OVER THE SEPTIC SYSTEM EXISTING STRUCTURE. THE SEPTIC TANK SHALL BE CONSTRUCTED OVER THE SEPTIC SYSTEM EXISTING STRUCTURE. THE SEPTIC TANK SHALL BE CONSTRUCTED OVER THE SEPTIC SYSTEM EXISTING STRUCTURE.
4. THE SEPTIC TANK SHALL BE CONSTRUCTED OVER THE SEPTIC SYSTEM EXISTING STRUCTURE. THE SEPTIC TANK SHALL BE CONSTRUCTED OVER THE SEPTIC SYSTEM EXISTING STRUCTURE.
5. THE SEPTIC TANK SHALL BE CONSTRUCTED OVER THE SEPTIC SYSTEM EXISTING STRUCTURE. THE SEPTIC TANK SHALL BE CONSTRUCTED OVER THE SEPTIC SYSTEM EXISTING STRUCTURE.
6. THE SEPTIC TANK SHALL BE CONSTRUCTED OVER THE SEPTIC SYSTEM EXISTING STRUCTURE. THE SEPTIC TANK SHALL BE CONSTRUCTED OVER THE SEPTIC SYSTEM EXISTING STRUCTURE.
7. THE SEPTIC TANK SHALL BE CONSTRUCTED OVER THE SEPTIC SYSTEM EXISTING STRUCTURE. THE SEPTIC TANK SHALL BE CONSTRUCTED OVER THE SEPTIC SYSTEM EXISTING STRUCTURE.
8. THE SEPTIC TANK SHALL BE CONSTRUCTED OVER THE SEPTIC SYSTEM EXISTING STRUCTURE. THE SEPTIC TANK SHALL BE CONSTRUCTED OVER THE SEPTIC SYSTEM EXISTING STRUCTURE.
CONSTRUCTION NOTE:

CONSTRUCTION NOTE: CONSTRUCTION SHALL BE IN ACCORDANCE WITH ALL APPLICABLE TOWN AND STATE REGULATIONS UNLESS OTHERWISE NOTED.

CONTRACTOR:

CONTRACTOR: [Name]

DATE:

DATE: [Date]

SCALE:

SCALE: [Scale]

PROJECT:

PROJECT: [Project Name]

FILE:

FILE: [File Name]

NOTE: THIS PLAN DOES NOT REPRESENT A PROPERTY BOUNDARY SURVEY.

CONSTRUCTION NOTE:
CONSTRUCTION SHALL BE IN ACCORDANCE WITH ALL APPLICABLE TOWN AND STATE REGULATIONS UNLESS OTHERWISE NOTED.